

Scale: 1:15,000
 Datum: GDA94 / Projection: MGA
 Map Sheets:
 1:25,000 Taree 9334-2-S
 1:100,000 Wingham 9334
 Contour Interval: 10 m

Harvest Plan Operational Map

Compartments 16, 17, 18, 19, 20


Kiwarra State Forest

Central Region - Taree Management Area

APPROVED
 RM Approval Date: 29.08.13
 Amendment Date: 17.06.14
 Controlled Map: Kiwarra 17181920_HPOM_Amend June14.pdf
 Amendment Date: 7.07.2015
 Controlled Map: Kiwarra17_20_NewArea_9July2015_Amend2_LIDAR_IFOA_Remake_TMTs



Prepared by: Ken Drew
 Date: 07/06/2012
 Amended by: B. Bailey
 July 2015

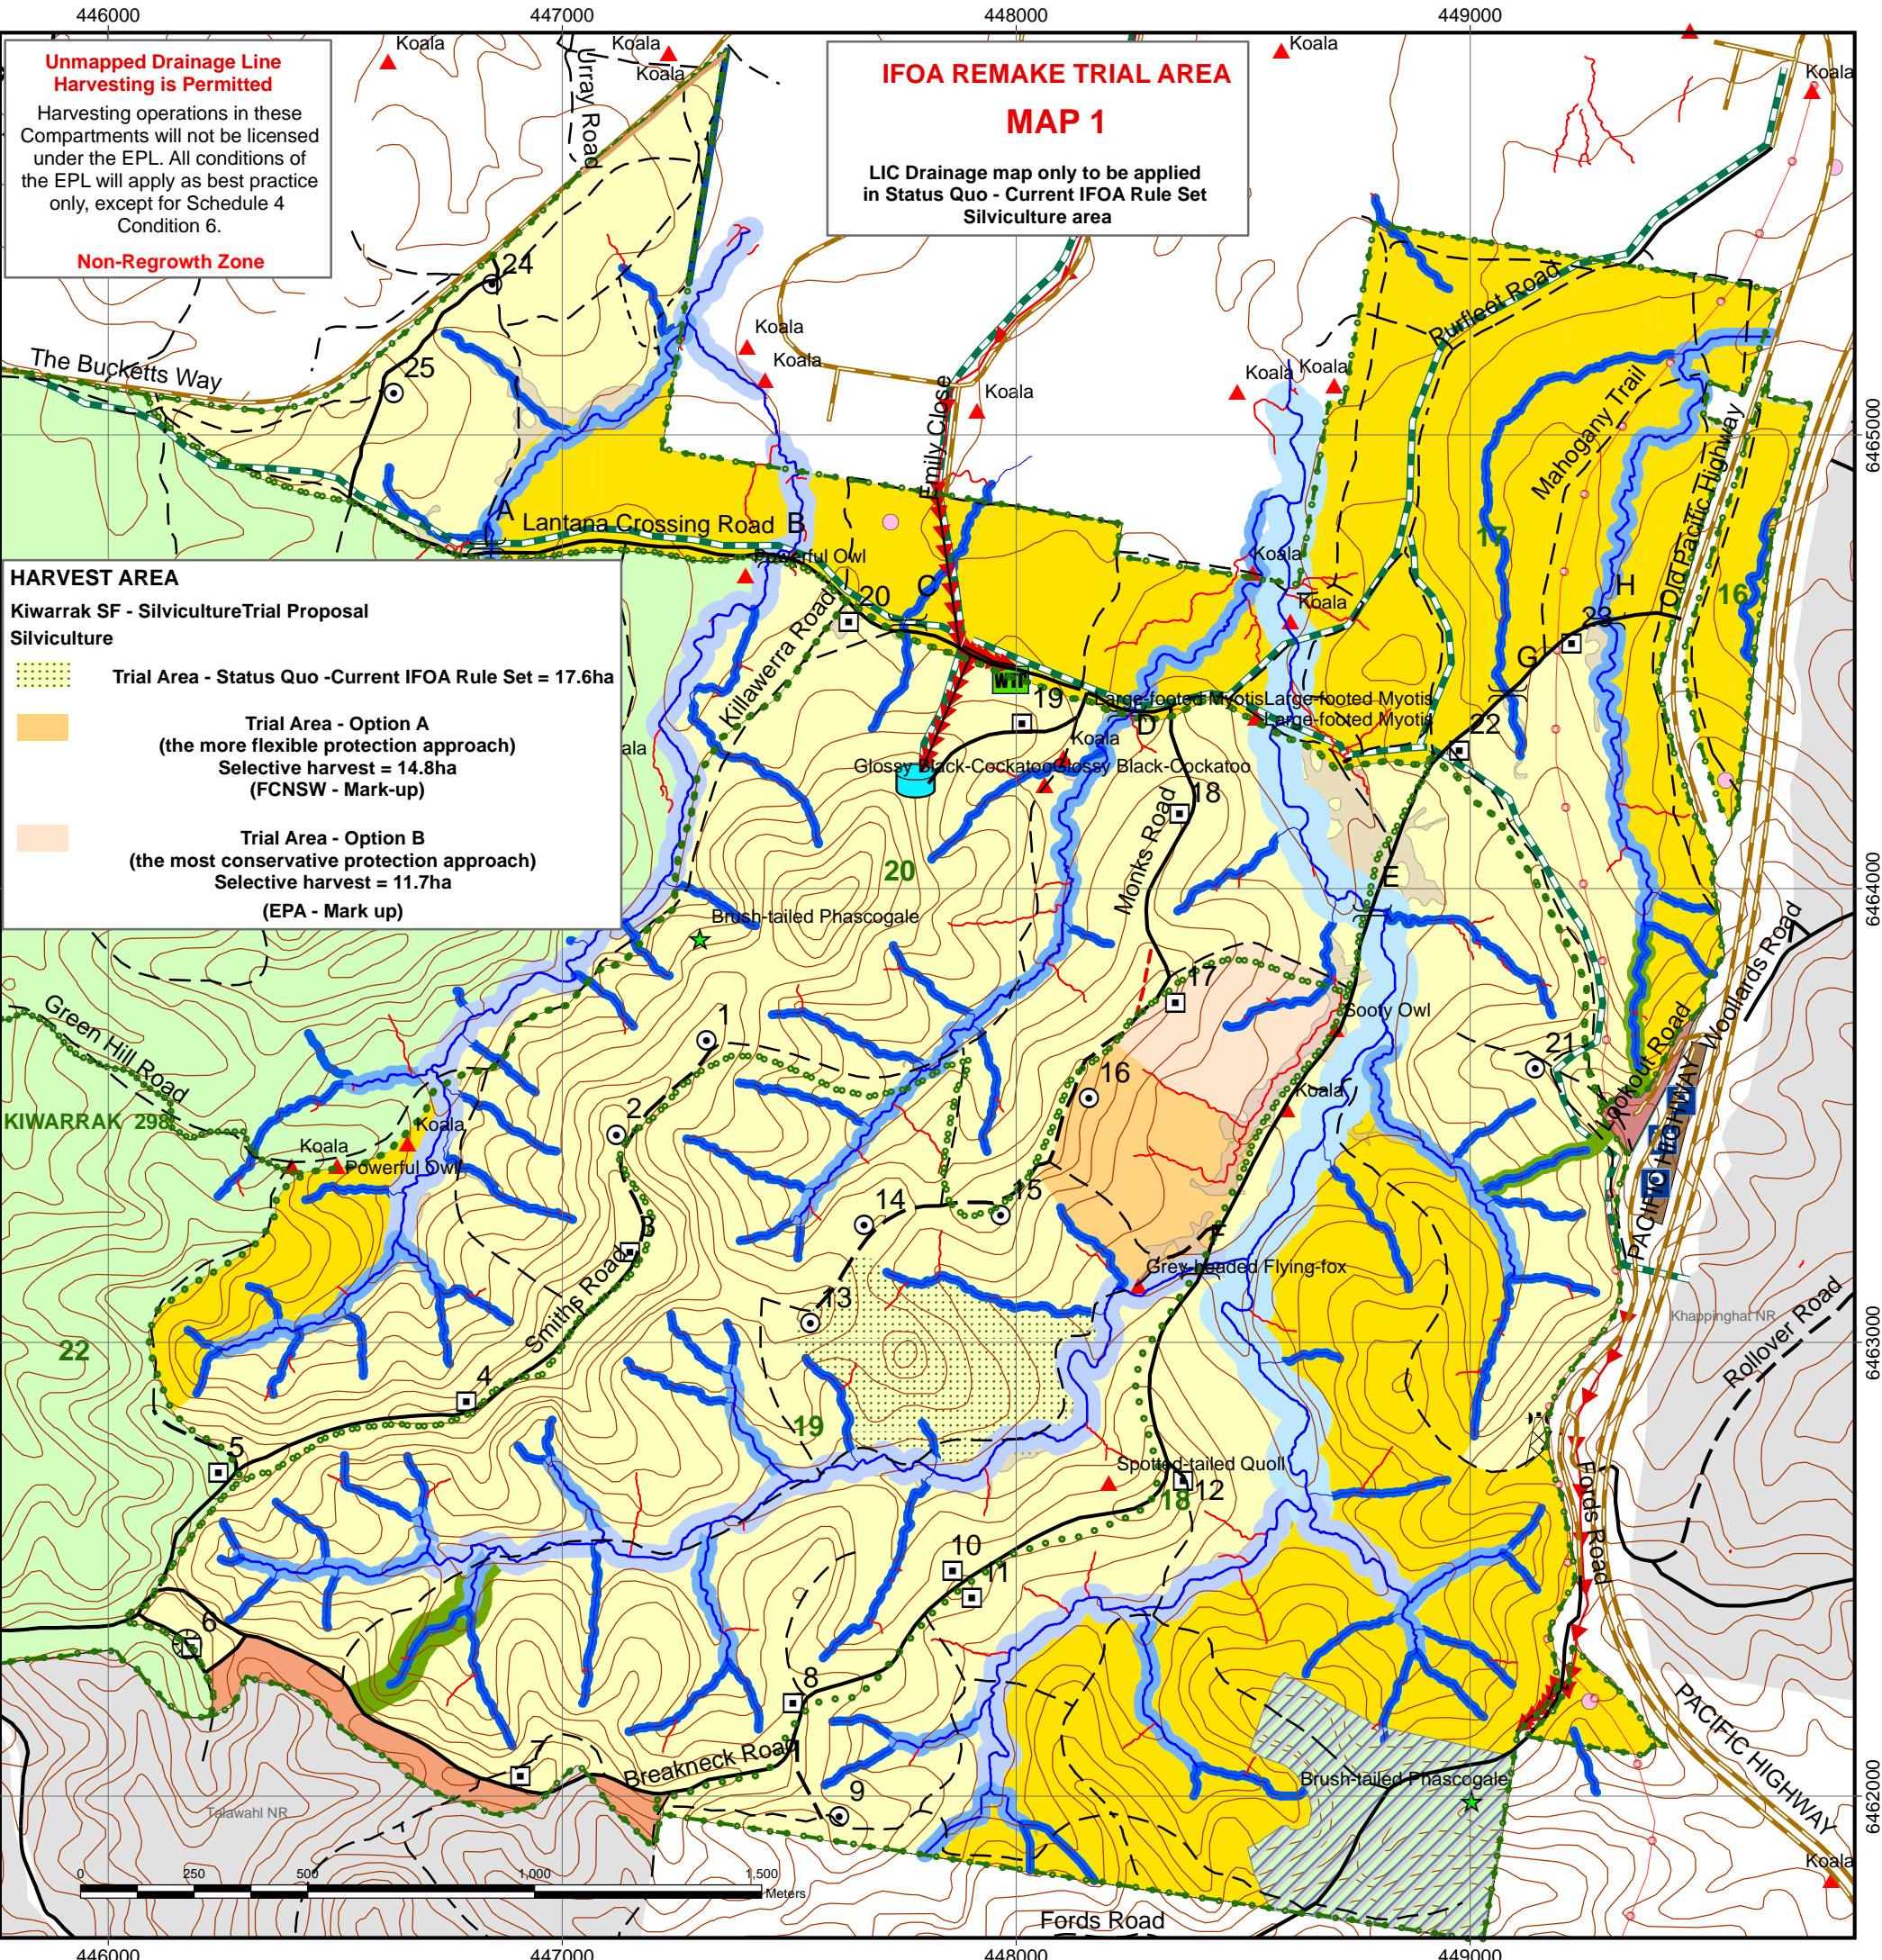

Unmapped Drainage Line
 Harvesting is Permitted
 Harvesting operations in these Compartments will not be licensed under the EPL. All conditions of the EPL will apply as best practice only, except for Schedule 4 Condition 6.
Non-Regrowth Zone

IFOA REMAKE TRIAL AREA
MAP 1
 LIC Drainage map only to be applied in Status Quo - Current IFOA Rule Set
 Silviculture area

HARVEST AREA
 Kiwarra SF - Silviculture Trial Proposal
 Silviculture

- Trial Area - Status Quo - Current IFOA Rule Set = 17.6ha
- Trial Area - Option A (the more flexible protection approach)
 Selective harvest = 14.8ha (FCNSW - Mark-up)
- Trial Area - Option B (the most conservative protection approach)
 Selective harvest = 11.7ha (EPA - Mark up)

MAP FEATURES	OTHER MAP FEATURES	HARVEST AREA & EXCLUSION ZONES	DRAINAGE FEATURES
State Forest Boundary	Rest area Toilets Parking Area	Base Net Area - (IHC 1&2)	Spatially Corrected LIC Drainage (using LiDAR) (5m Operational Zone)
Compartments Boundary	Pump Station	Harvest Area	1st Order (Protection 10m)
10 / 100 m Contour	Reservoir	General Management (FMZ 4 and 8)	2nd Order (Protection 20m)
State Forest	Telstra Tower	Basal Area Offset (not to be logged)	3rd Order (Protection 30m)
Private Property (cadastre)	Pacific Hwy Rest Area	EXCLUSIONS	4th order & above (Protection 50m)
Incorrect Fenced Boundary (refer - HP)	Aboveground Powerline	National Park	LiDAR Unmapped Drainage lines
ROADS, DUMPS & CROSSINGS	Underground Power Line	4 Bar Exclusions	Water Point
Sealed Road	telstra Cable	EEC Exclusion (Alluvial Soils) Indicative.	
Gravel Road	MCW_Water Pipe Lines	Talawahl NR Buffer - Logging Excluded	
Natural Surface Road	PGP (Permanent Growth Plots)	School Visual Buffer (10m - refer HP)	
Not to be used for haulage	Modified Harvest Area	3 Bar Exclusions (Limited Falling)	
New construction	Water body	Harvesting Protection (FMZ 3A)	
Temporary Dry		Ridge & Headwater Habitat (40m/80m exclusion)	
Temporary Wet		RTA Acquired Land	
Approved Crossing			Threatened Species Records
Quarry			<i>Records requiring prescription</i>
			Brush-Tailed Phascogale record
			Brush-Tailed Phascogale Exclusion
			Ecology point site (labelled on map)